


**1 BASEMENT DEMOLITION & CONSTRUCTION PLAN**  
 90-E2.1 SCALE: 1/8" = 1'-0"

## SHEET NOTES

1 CONNECT TO PNL 90A11A7B-7

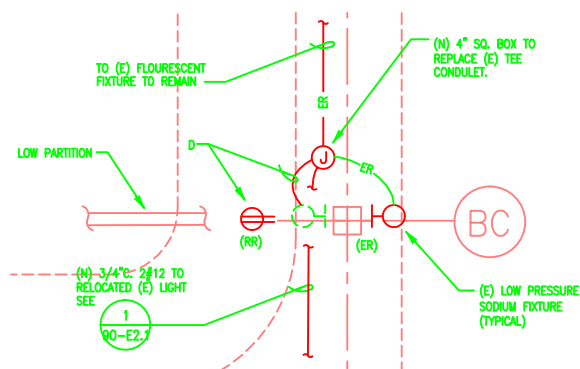

**DETAIL**  
SCALE: 1/4" = 1'-0"

## DESIGN CRITERIA

7. PROVIDE CONTINUOUS ILLUMINATION FOR THE FOURTH FLOOR EXIT ACCESS TO THE WEST STAIRWAY. LIGHTS ARE CURRENTLY CONNECTED TO BOTH WALL SWITCH AND MOTION DETECTOR.
8. PROVIDE A CODE COMPLIANT ACCESS TO THE EXTERIOR STAIRWAY ON THE EAST SIDE OF THE BUILDING ON THE FOURTH FLOOR.
9. PROVIDE CODE REQUIRED PROTECTION FOR THE EXTERIOR STAIRWAY ON THE EAST SIDE OF THE BUILDING.
158. PROVIDE AN ENCLOSED RATED PASSAGEWAY FROM THE CENTRAL STAIRWAY TO THE EXTERIOR.
199. SURVEY ALL EXIT LIGHTING AND PROVIDE EMERGENCY ILLUMINATION AS REQUIRED.



**ESS ARCHITECTS**  
466 Eighth Street  
San Francisco, CA 94103  
415 252-9500  
415 252-1585 Fax

## CONSULTANT

**MAZZETTI & ASSOCIATES, INC.**  
Consulting Mechanical & Electrical Engineers  
1000 BROADWAY STREET - SAN FRANCISCO, CA 94103-0877  
TELEPHONE (415) 864-5800 FAX (415) 864-4303  
# 621-285

## REVISIONS

no.	date	description
A	9/26/94	90% TITLE II
B	11/7/94	100% TITLE II
C	2/13/95	FINAL TITLE II
D		REVISED LIG FEATURE, TYPE AND PHIL CRT MODS. BY LIGL
E	7/25/97	AS BUILT

JOB TITLE

FIRE AND SAFETY SYSTEMS UPGRADE  
PHASE I  
LAWRENCE BERKELEY LABORATORY, UNIVERSITY OF CALIFORNIA  
BERKELEY, CALIFORNIA

**KEY PLAN**

ESS ARCHITECTS JOB #: 9292

LBL SC#: 728

LBL FILE DRAWING: \*

ACAD FILE NAME:

LBNL  
DWG. 3N90E124E  
PROJ # 120257

SHEET TITLE:  
BUILDING 90  
BASEMENT  
DEMO & CONSTRUCTION PLAN

SCALE: AS NOTED		DATE: 2/13/95
-----------------	--	---------------

SHEET: 90-E2.1E 